


*Markup are provided merely for
visualization purpose and are not to be
interpreted as being exactly to scale.
(Arrows indicating which side of the BCR
the down guy will need to be relocated to.)

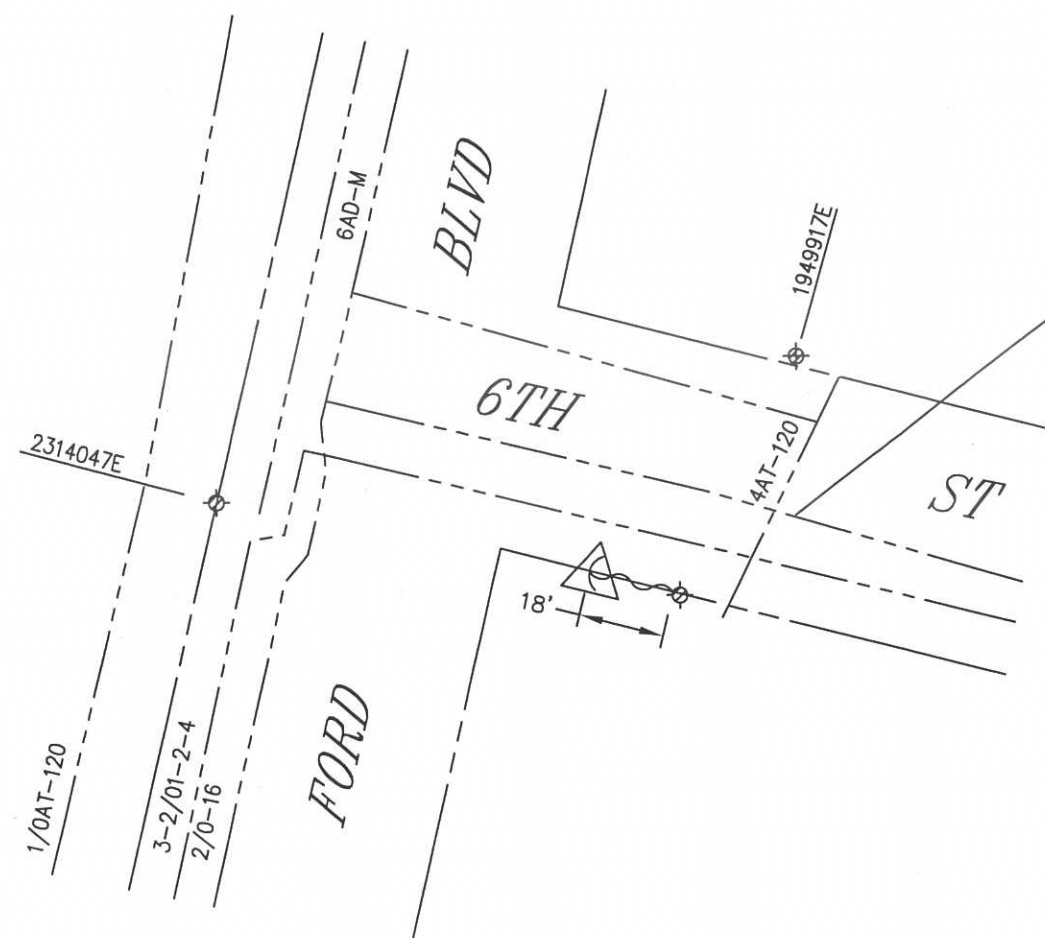

- NOTES:**
- RELOCATE EXISTING DOWN GUY 18' FROM EXISTING POLE.
 - PLEASE TRY TO PUT ANCHOR AS CLOSE TO FENCE AS POSSIBLE.
 - REMOVE & INSTALL NEW ANCHOR

EXISTING 834261E 1

55' Class C2

FR: 1- AG ANCHOR ROD 1" X 10' 3-EYE W/PLATE

FR: 3- AG DOWN GUY 3/8" - 50' LESS THAN 22.5KV

FI: 1- AG ANCHOR ROD 1" X 10' 3-EYE W/PLATE

FI: 3- AG DOWN GUY 3/8" - 50' LESS THAN 22.5KV

PROJECT REQUIREMENTS	
EDISON EASEMENT REQUIRED	<input type="checkbox"/> N
PWRD 88 REQUIRED	<input type="checkbox"/> N
PERMIT REQUIRED	<input checked="" type="checkbox"/> Y
PERMIT TYPE: ENCROACHMENT	
OUTAGE REQUIRED	<input type="checkbox"/> N
TRAFFIC CONTROL REQUIRED	<input type="checkbox"/> N
PED. TRAFFIC CONTROL REQ'D	<input checked="" type="checkbox"/> Y
CONVEYANCE LETTER REQ'D	<input type="checkbox"/> N



SCALE: 1" = 40'

0 40 80

BURGER 4KV O/O BICKNELL SUB

GLEASON 16KV O/O REPETTO SUB

DISTRICT 22 - MONTEBELLO		PROJ. MGR. ALATORRE, ELDA M PHONE 323-720-5214		PLANNER ALATORRE, ELDA M PHONE 323-720-5214			
FOREMAN		TRUCK NO. P/E		INVENTORY MAP NO. THOMAS GUIDE 122-4236-1		GRID NO. DESIGN NO. 648771_0.01	
CSD 140	Y <input type="checkbox"/> N <input type="checkbox"/>	BY-PASS CODE	EXISTING CHANGE TO	TLM CHECKED	%LOAD	J.P.A. NO.	ASSOCIATED DESIGN NO.
PRODUCT/SAP NO. 933212-RELOCATE FACILITIES(FUNCTION WORK ONLY)				PRODUCT/SAP NO.		PRODUCT/SAP NO.	
				PROPOSED CONSTRUCTION (LOCATION) RELOCATE DOWN GUY 4506 6TH LOS ANGELES CA 90022 LOS ANGELES			
TYPE	APPROVED BY	DATE	CHECKED BY	DRAWN BY	PAX #	SHEET 1 OF 1	JOB NO. 648771_0.01
Southern California Edison Company							